


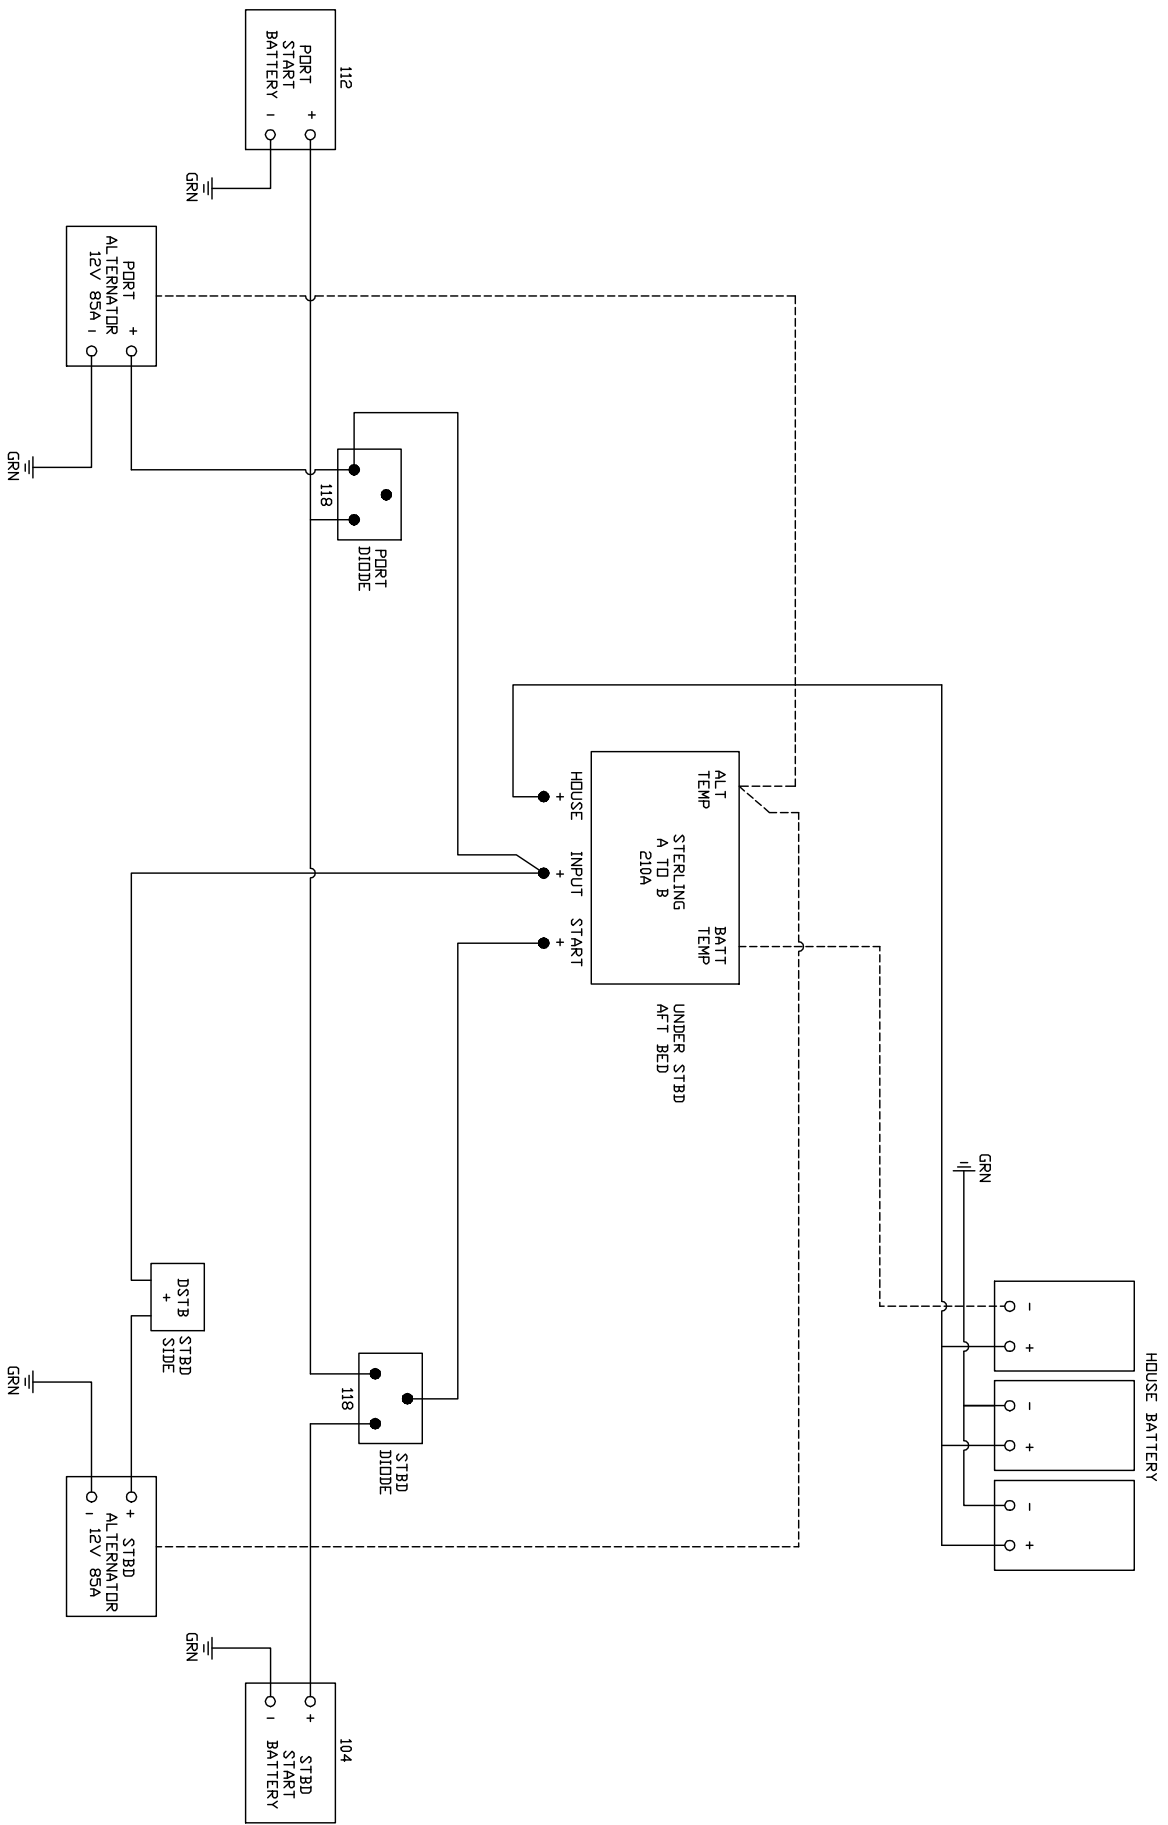

**Electrical Marine Systems Ltd**

Copyright: This drawing and detail belong to Electrical Marine Systems Ltd and are not to be reproduced without written approval from: **Electrical Marine Systems Ltd** PO Box 1395, Whangarei, NZ E-MAIL: electrical@ems.co.nz

Project:	DAVE SAGGS	Drawn by:	PK	Revision:	Original
Drawing Title:	STERLING POWER SYSTEM SCHEMATIC DIAGRAM	Checked by:		Drawing Number	EMS 763 B2 A

AS BUILT

LAST CABLE